




NO.	REVISIONS
1	AS SHOWN
2	REVISED TO REFLECT CHANGES FROM 10/17/2001
3	REVISED TO REFLECT CHANGES FROM 11/12/2001
4	REVISED TO REFLECT CHANGES FROM 11/27/2001
5	REVISED TO REFLECT CHANGES FROM 12/13/2001
6	REVISED TO REFLECT CHANGES FROM 12/20/2001
7	REVISED TO REFLECT CHANGES FROM 1/3/2002
8	REVISED TO REFLECT CHANGES FROM 1/10/2002
9	REVISED TO REFLECT CHANGES FROM 1/17/2002
10	REVISED TO REFLECT CHANGES FROM 1/24/2002

CE Group, Inc.
LAND USE EVALUATION
AND USE EVALUATION
CONSTRUCTION MANAGEMENT

Chatham County, North Carolina
Sandhills Grading
Landscape Plan
FINAL - APPROVED

Date: JAN. 9, 2001
Scale: 1" = 20'
Drawn: JFW
Checked: MPA
Project: 000-01
Computer: Insp. Name
11422-000000000

Sheet No. **L-1** of 1

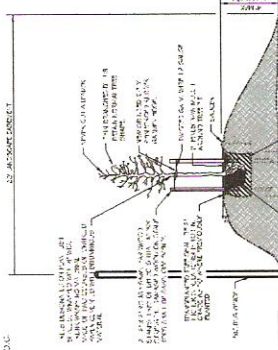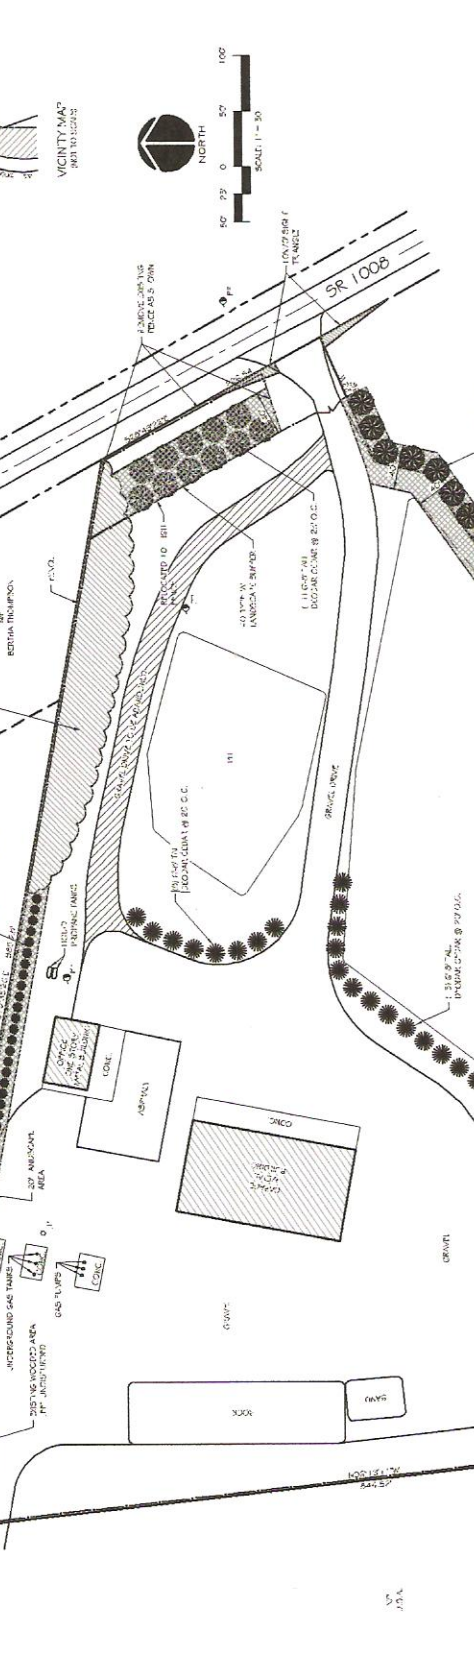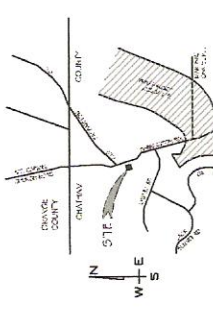

NOTE:
ONCE EACH PIT IS COMPLETELY FILLED WITH INERT DEBRIS, THE OWNER SHALL PLANT PINE SEEDLINGS.

RECORD DRAWING OF 2001 SUBMISSION

LANDSCAPE PLAN
SCALE: 1" = 50'

SITE DATA
SHEET NO. L-1 OF 1
PROJECT: SANDHILLS GRADING
DATE: 10/17/2001